


NO	DATE	DETAILS OF MODIFICATION	CHECKED
A	20.03.09	GENERAL REVISIONS AS PER ARCHITECT'S COMMENTS	G.E.C.
B	07.04.09	GENERAL REVISIONS AS PER ARCHITECT'S COMMENTS	G.E.C.
C	11.04.09	PANEL EXTENDED TO SUIT S.H.S. POSITIONS	G.E.C.
D	17.04.09	PANEL SET-OUT AND ATM POSITIONS ADJUSTED TO SUIT ATM CLEARANCE	G.E.C.
E	27.04.09	PANEL JOINT RE-POSITIONED	G.E.C.
F	01.05.09	COMMENT ADDED	G.E.C.

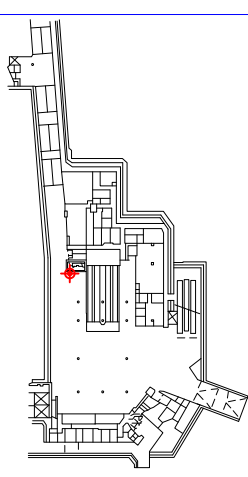

GENERAL NOTES:

ALL MATERIAL 316 GRADE STAINLESS STEEL.

ALL WELDS LEFT AS LAID AND ACID CLEANED, UNLESS OTHERWISE STATED.

ALL VISIBLE SURFACES SHOT PEENED TO APPROVED SAMPLE FINISH.

ALL VISIBLE FIXINGS TO BE M6 CSK SETS.

ALL EXPOSED EDGES TO BE GROUND SMOOTH.

EARTH BONDING REQUIRED TO CLADDING PANELS AND FRAMING.

SEE DRG NO. 73401 FOR REAR FRAMEWORK DETAILS.

AS-BUILT DRAWING

Marked-up By: _____

Checked: _____

Signature	Print Name	Date

DESIGNED BY: **Hi-Spec**

HI-SPEC ENGINEERING LTD

UNIT 9 WINDHILL IND. EST., WINDHILL, FOWEY, CORNWALL, PL23 1HB
TEL: 01726 833644 FAX: 01726 833611

CONTRACT NO: KE0309 DRAWN BY: G. COOKE APPROVED BY: G. COOKE

ORIGINAL SCALE/FRAME: 1:20 @ A1 19.02.09 20.02.09

TITLE: STAINLESS STEEL CLADDING LAYOUT ATM

DRG NO: R946/BBCEL/NTH/SSWP/

NO: DRG/GEN/XXXX